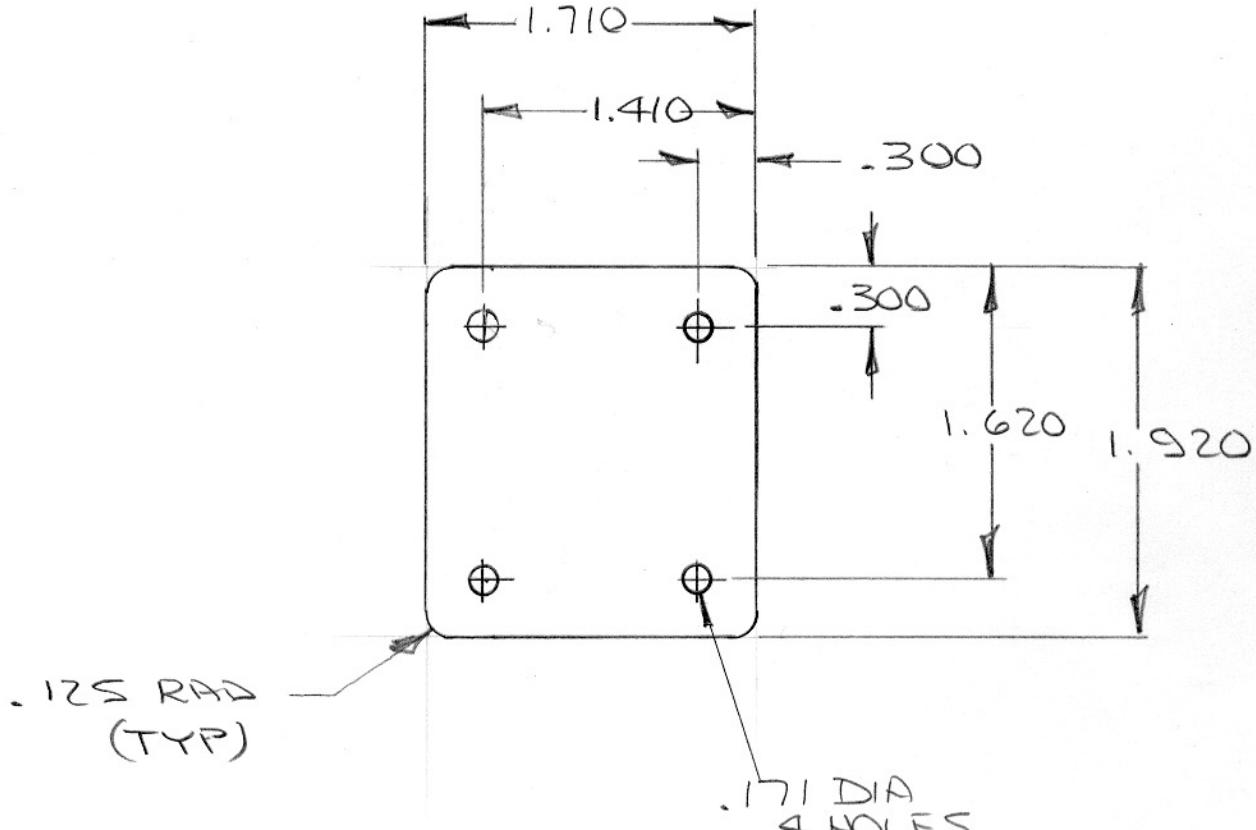


**DART**

DRAWN BRADLEY 94.3.23	DART AERO ACCESSORIES INC VICTORIA INTERNATIONAL AIRPORT, CANADA	
DESIGN BRADLEY 94.3.23	DRAWING NO. <b>D2228</b>	REV. <b>B</b>
STRESS	TITLE BACKING PLATE	SHEET 1 OF 1
B	00.09.11	UPDATE FINISH SPEC. <del>CP</del>

**RELEASED**  
00.04.12 ~~H~~

MATERIAL : 5052-H32 .063 THICK  
(QQ-A-250/8)

FINISH : **B** CHEMICAL CONVERSION COAT PER DART QSI 005 4.1  
POWDER COAT WHITE (REF 4.3.5.1) PER DART QSI 005 4.3